


LOT AREA = 2302 m2



KEY PLAN
N.T.S

Scale Bar:

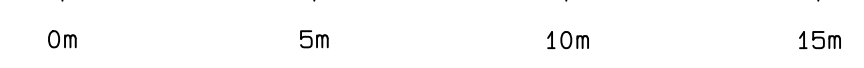

Benchmark:

No.	DESCRIPTION	ELEVATION
BM#1	NAIL IN ASPHALT DRIVEWAY	100.00m

NO.	REVISION/ISSUE	DATE
4	DIMENSIONS ADDED	22/09/21
3		16/09/21
2	ASBUILT SURVEY	16/10/13
1	ISSUED WITH ADDED GRADES	01/06/11
0	ISSUED FOR REVIEW	01/02/11

Client:
JEFF CAVANAGH

Project:
#311 STRATTFORD ROAD

Drawing Title:
EXISTING SITE PLAN

DRAWN BY: RSS	Project Number:
DESIGNED BY: RSS	
CHECKED BY: RSS	
PAPER SIZE: 24" x 36"	SCALE: H 1:150
DATE: FEBRUARY 1, 2011	Drawing Number: Sheet 1 of 1 01